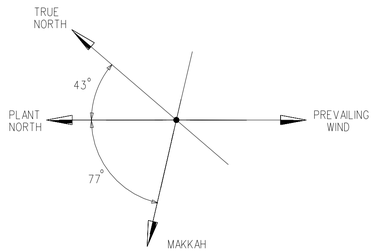

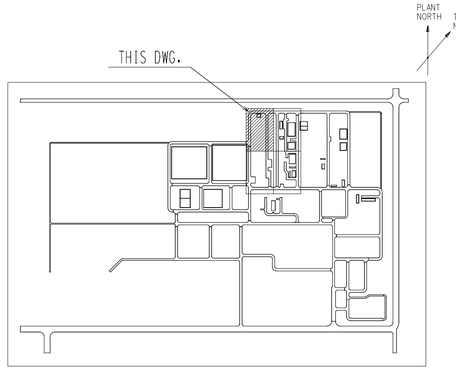

KEY PLAN

EQUIPMENT NO. DESCRIPTION

UNIT 32,33

E-3306	MAIN CONDENSER
P-3310	DM CONDENSATE CIRCULATION PUMP
V-3308	AFC GREASING SYSTEM
V-3307	AFC GREASING SYSTEM

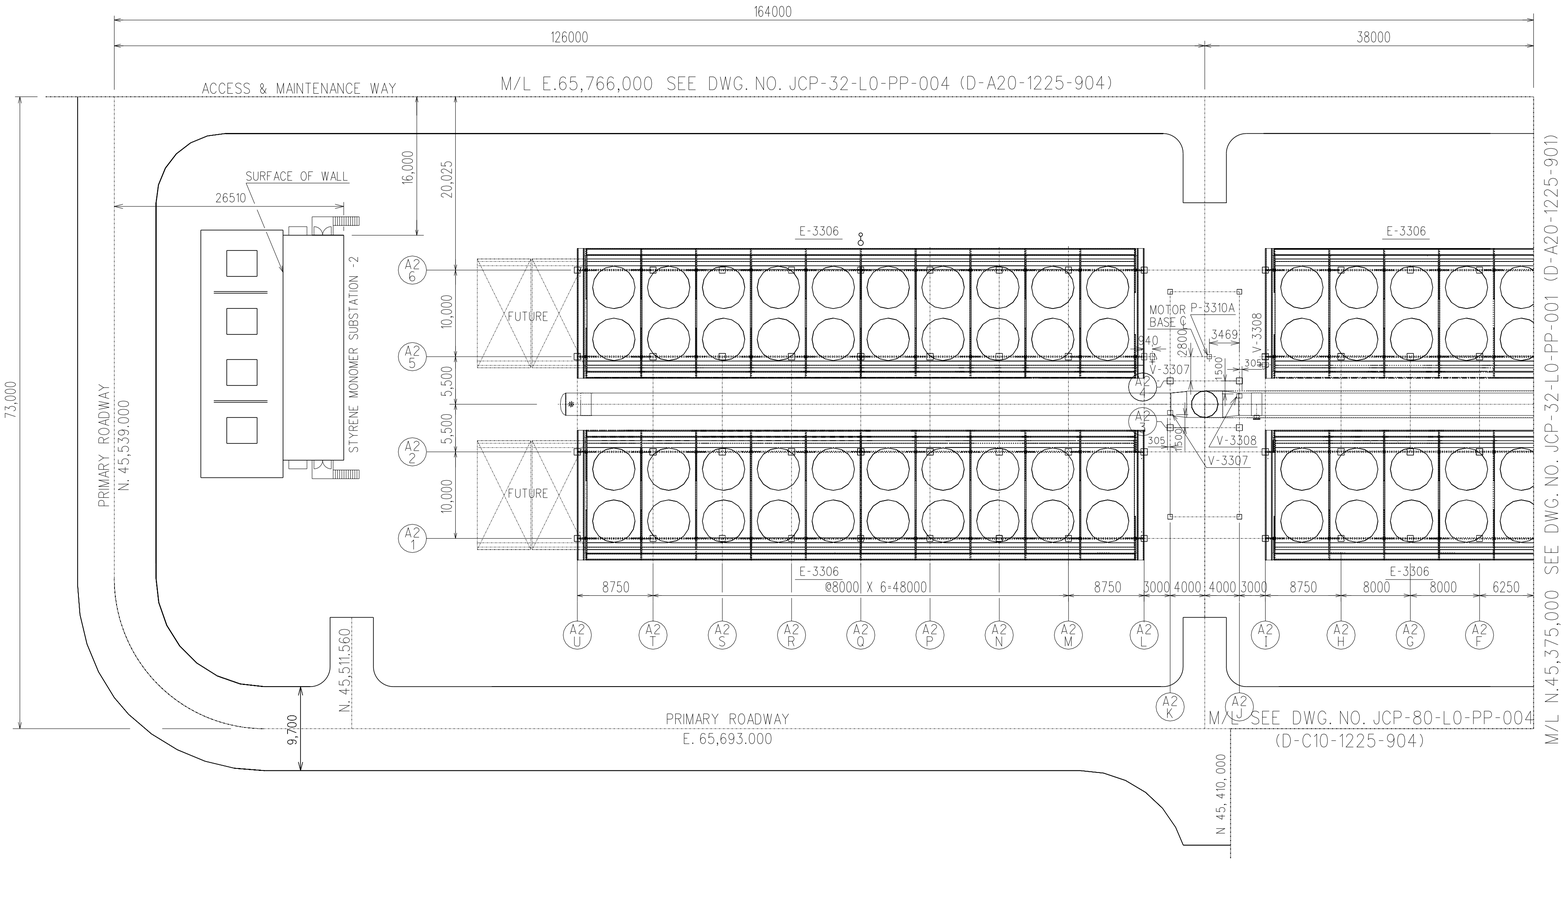

5000 0 5000 15000 25000 35000

SCALE IN MILLIMETERS

NOTES

1. GRADE ELEVATION (HIGHT POINT PAVING) SHOWN ON THIS DRAWING EL. 100,000
2. ALL COORDINATES ARE IN METERS.
3. ALL ELEVATIONS AND DIMENSIONS ARE IN MILLIMETERS.
4. ⊗ : SAFETY SHOWER/EYE WASH STATION.

REV.	DATE	DESCRIPTION	DRAWN	CHKD.	APPVD.	REFERENCE DRAWING
00	01 Dec 2007	As Built	R.Sanonte	Y.Yamamoto	HKaja	

CONFIDENTIAL INFORMATION - REPRODUCTION AND USE PROHIBITED EXCEPT IN ACCORDANCE WITH JUBAIL CHEVRON PHILLIPS COMPANY'S WRITTEN PERMISSION.

EPC CONTRACTOR JGC

MANAGING CONTRACTOR PARSONS E&C

JCP

	INITIAL	DATE
DRAWN		
CHECKED		
CONTRACTOR. APPROVAL		
JCP APPROVAL		
SCP REVISION		

TITLE

UNIT PLOT PLAN

UNIT 32,33

SCALE	PROJECT NO.	CONTRACT NO./ WORK ORDER NO.	DWG. NO.	REV
1:250			JCP-32-L0-PP-002	00

FILE NAME : D-A20-1225-902_C02_0001.dgn

0-3515-2

D-A20-1225-902 < 00 >

A0 1189x841